





# BROADWAY WEST

Suite 6800

As-Built      2,108 Sq. Ft.

\* Dimensions are Deemed  
as Accurate but not to Scale

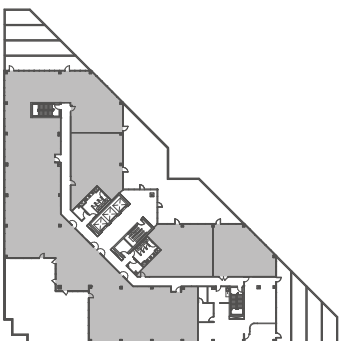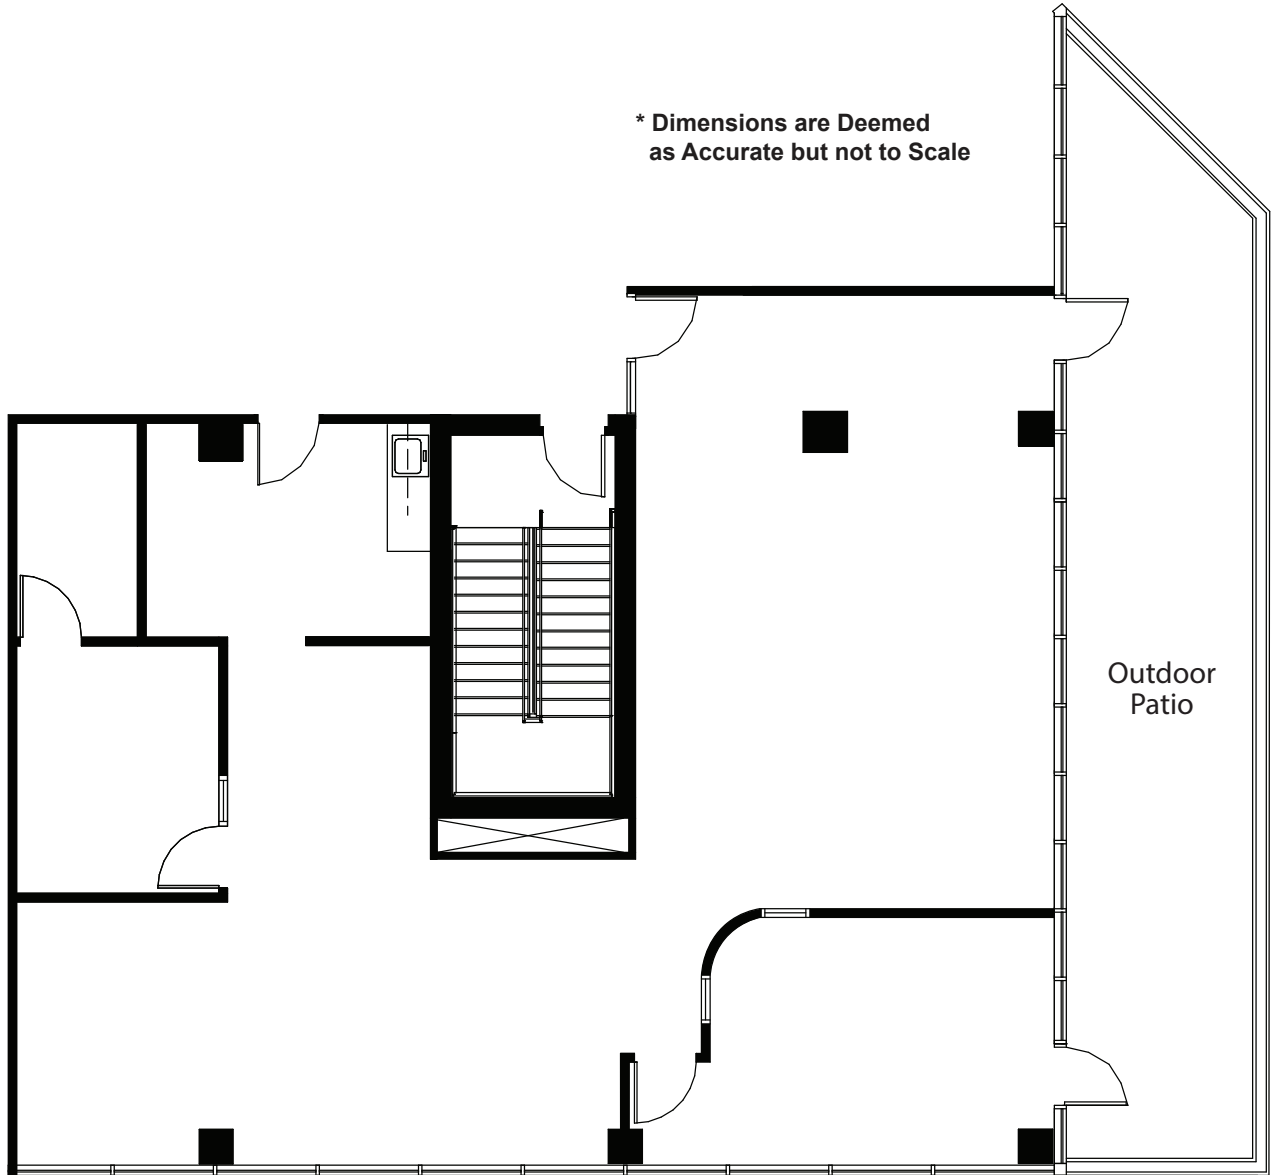

OWNED & MANAGED BY



LEASED BY

