



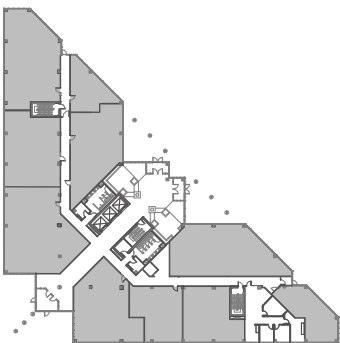

BROADWAY WEST

Suite 1900

As-Built 1,265 Sq. Ft.

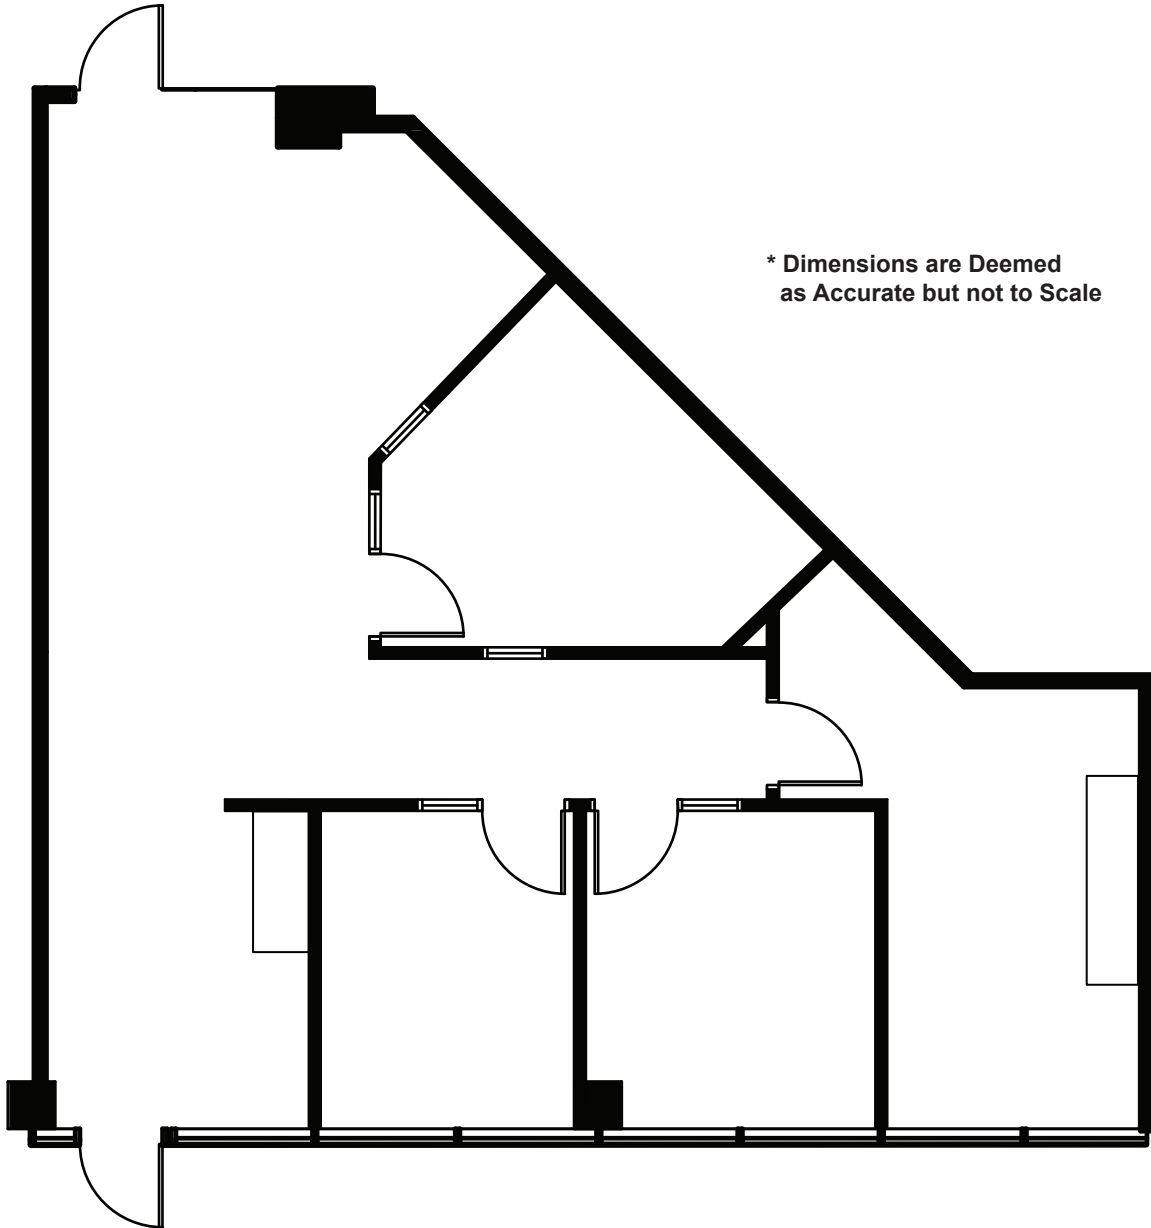

OWNED & MANAGED BY



LEASED BY

