





BROADWAY EAST

Suite 160

As-Built 1,390 Sq. Ft.

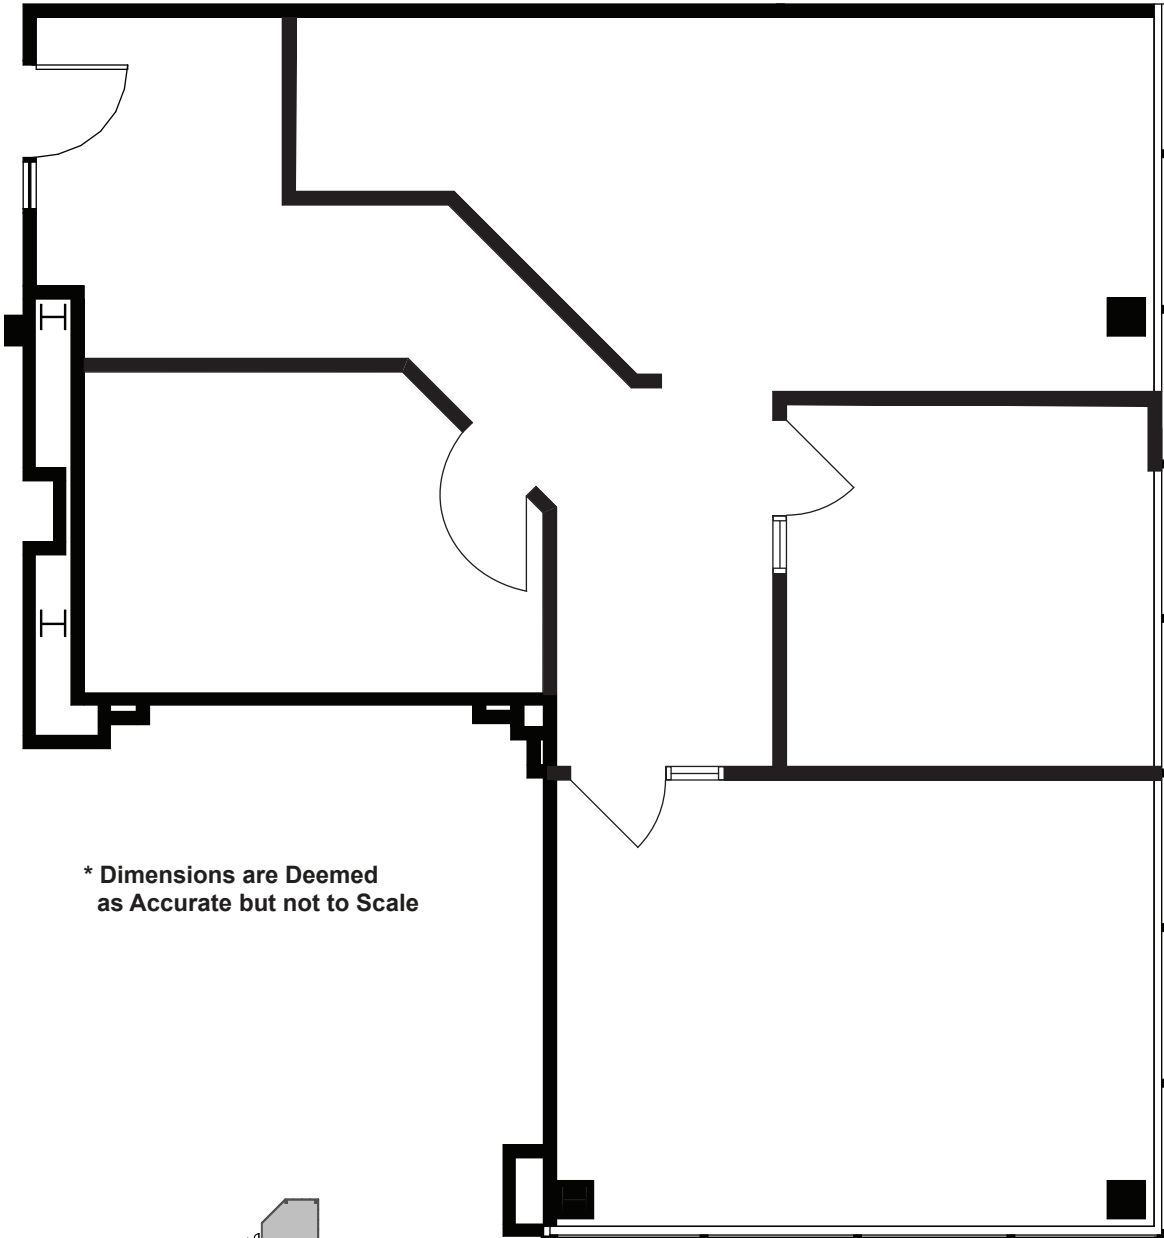

* Dimensions are Deemed
as Accurate but not to Scale

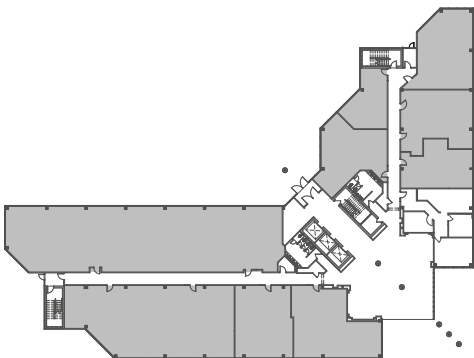

OWNED & MANAGED BY



LEASED BY

