





BROADWAY WEST

Suite 1725

As-Built 1,293 Sq. Ft.

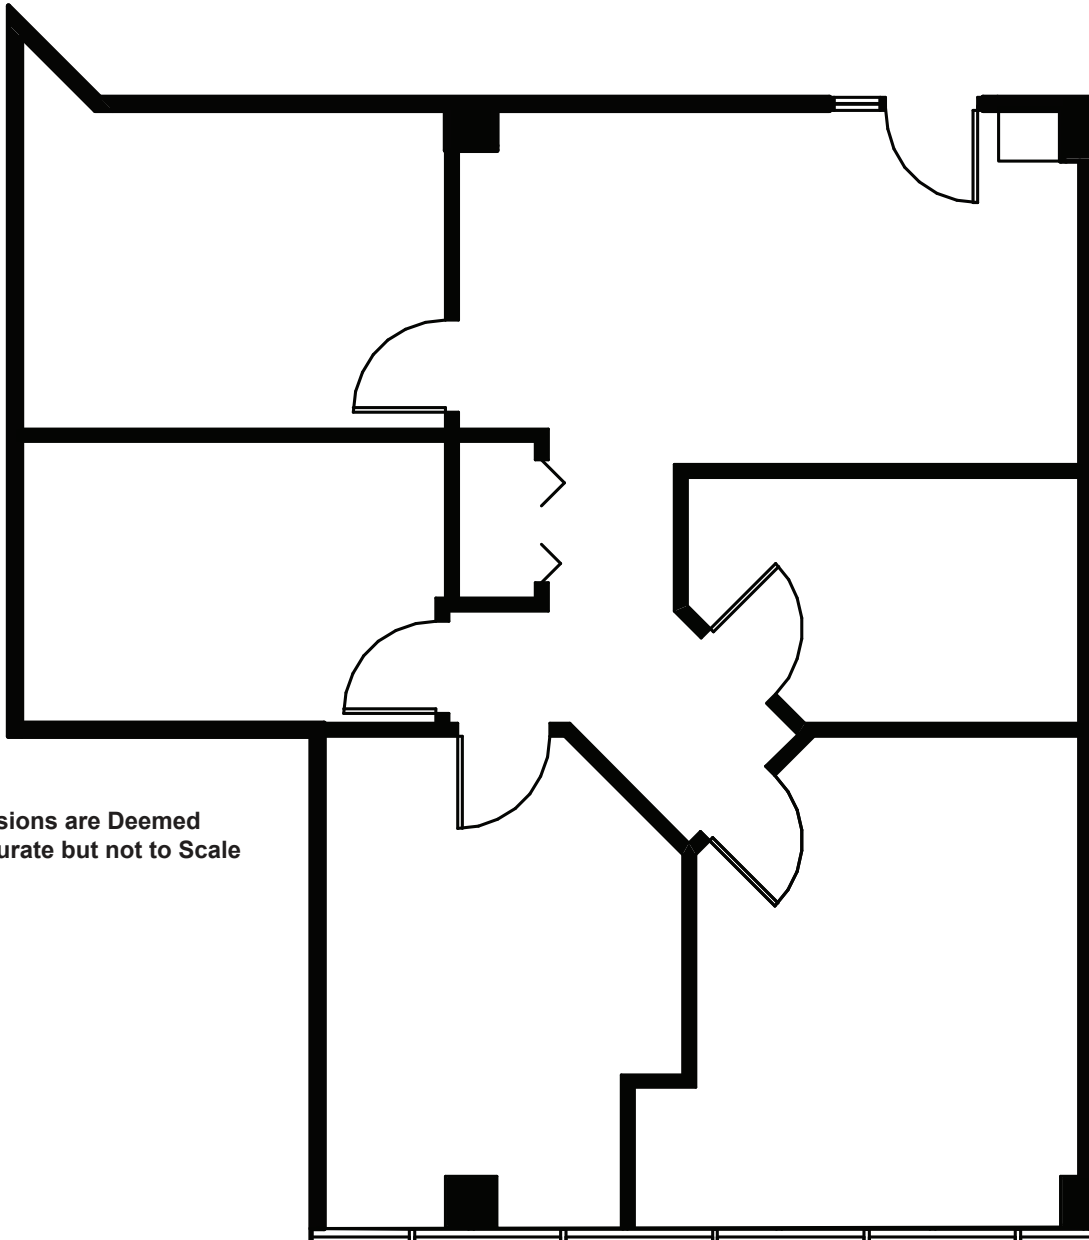

* Dimensions are Deemed
as Accurate but not to Scale

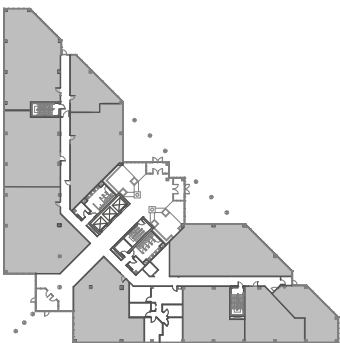

OWNED & MANAGED BY



LEASED BY

