



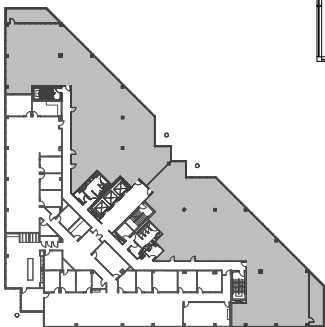

# BROADWAY WEST

Suite 4500

As-Built      11,763 Sq. Ft.

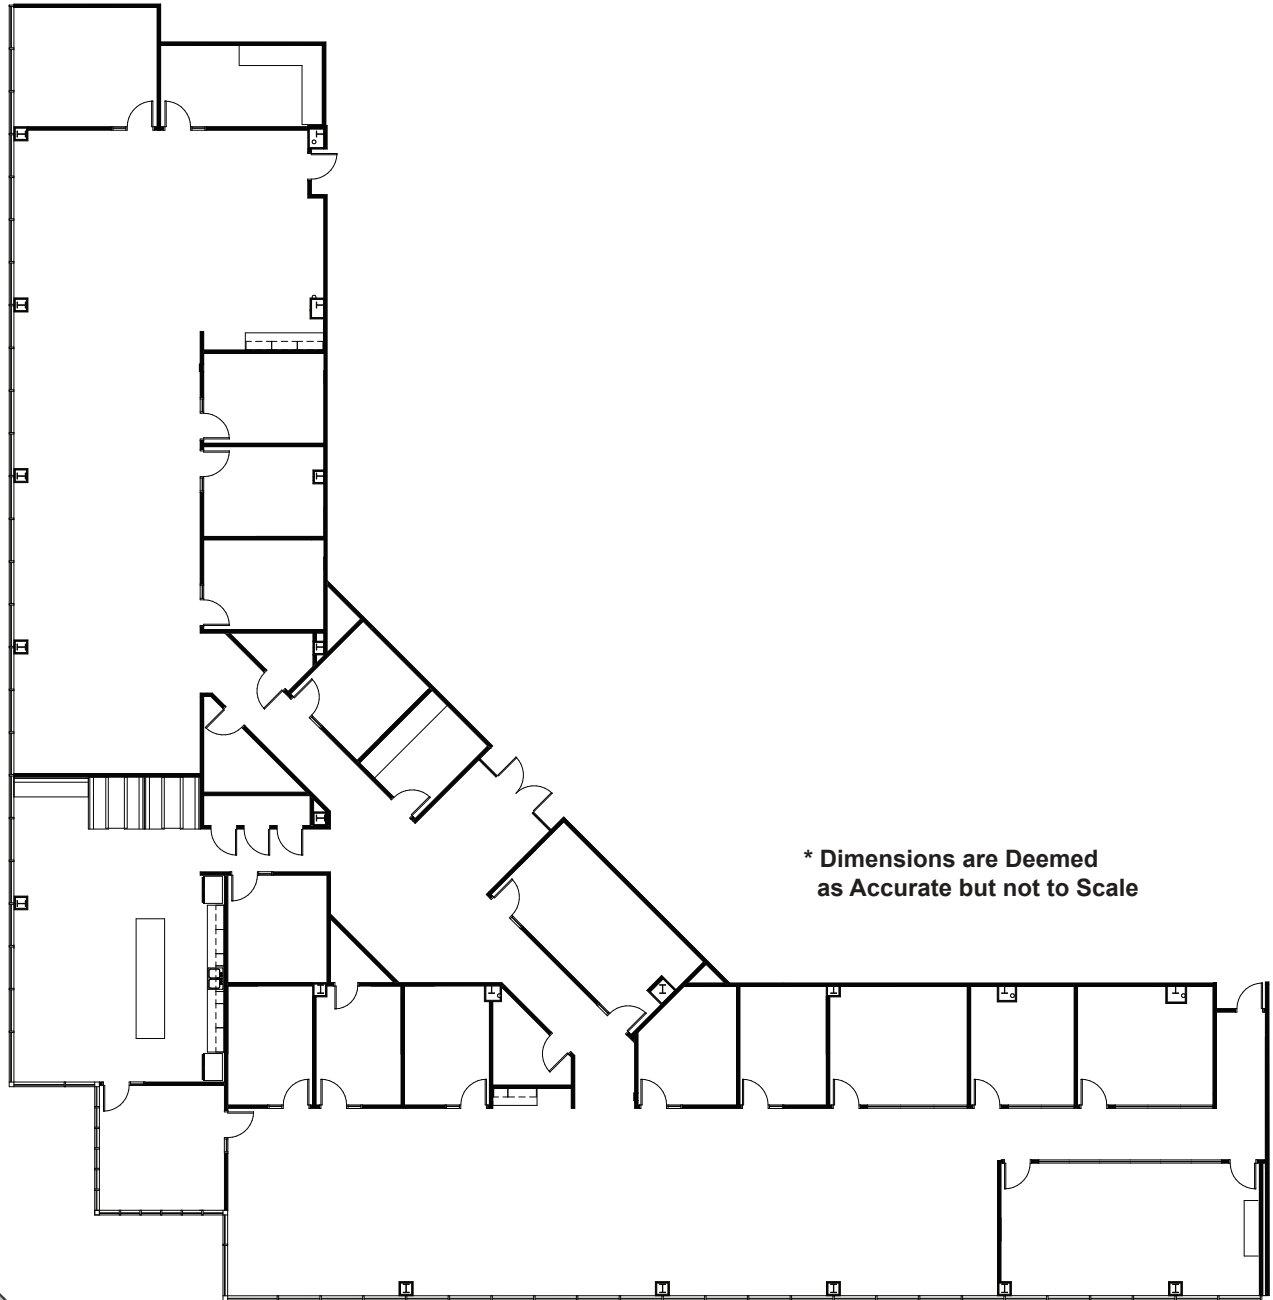

OWNED & MANAGED BY



LEASED BY

