




BROADWAY EAST

Suite 470

As-Built 1,216 Sq. Ft.



* Dimensions are Deemed
as Accurate but not to Scale

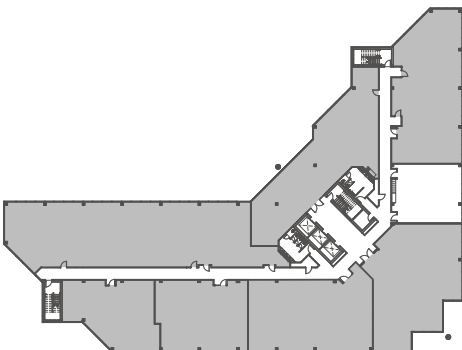

OWNED & MANAGED BY



LEASED BY

