





BROADWAY WEST

Suite 6250

As-Built 1,643 Sq. Ft.

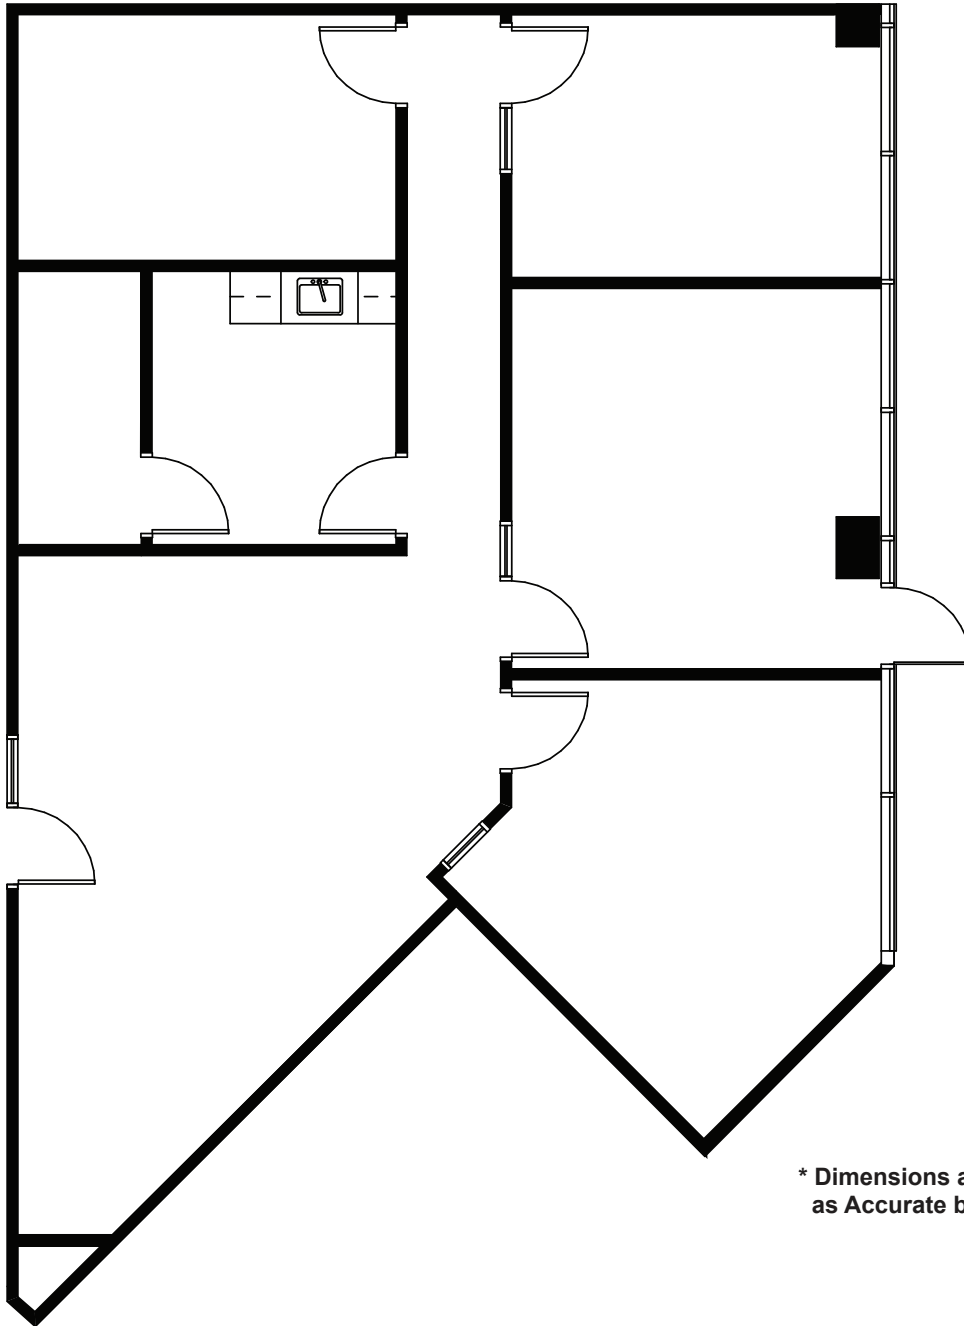

* Dimensions are Deemed
as Accurate but not to Scale

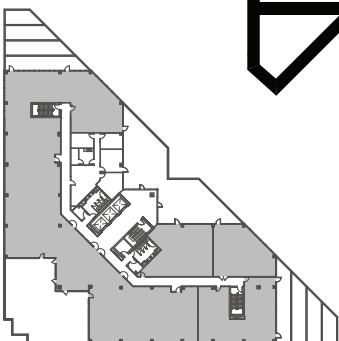

OWNED & MANAGED BY



LEASED BY

