





# BROADWAY EAST

Suite 455

As-Built

5,238 Sq. Ft.

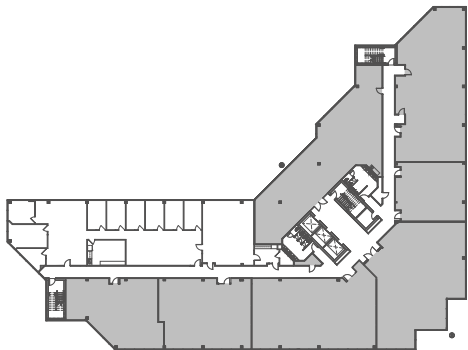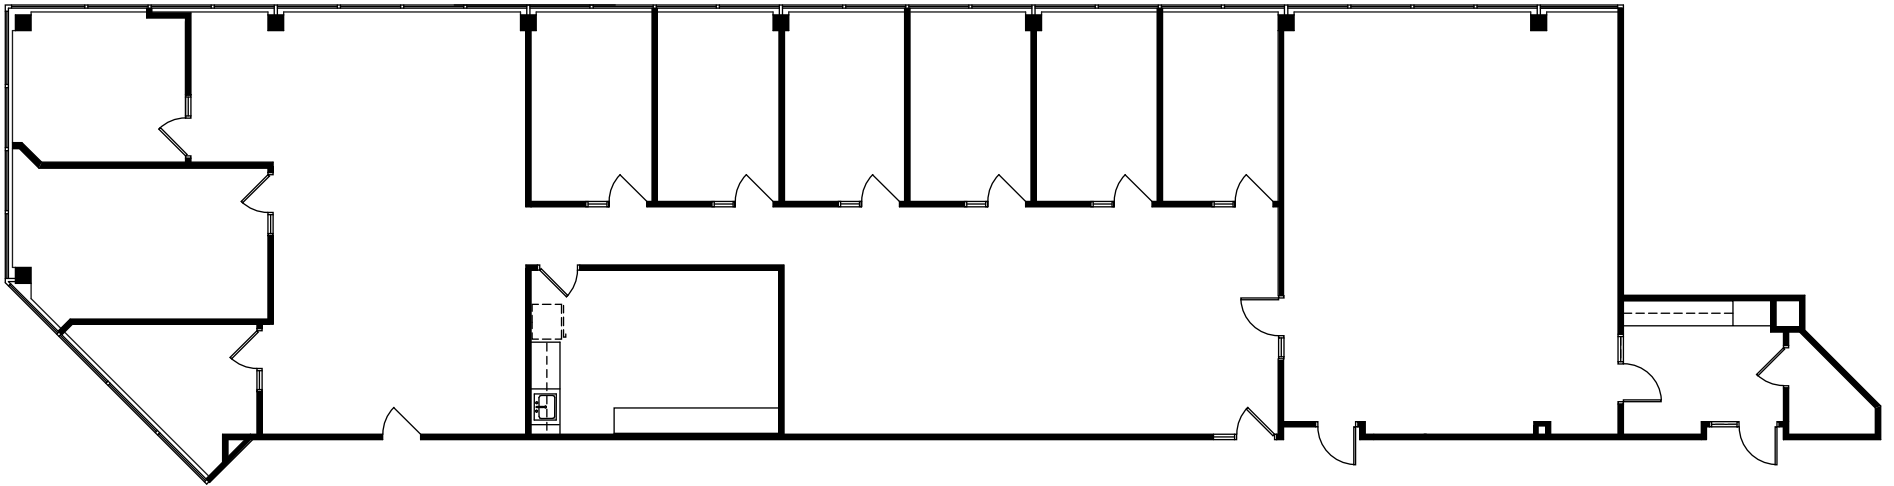

\* Dimensions are Deemed  
as Accurate but not to Scale

OWNED & MANAGED BY



LEASED BY

