





BROADWAY EAST

Suite 510

As-Built

9,217 Sq. Ft.

* Dimensions are Deemed
as Accurate but not to Scale

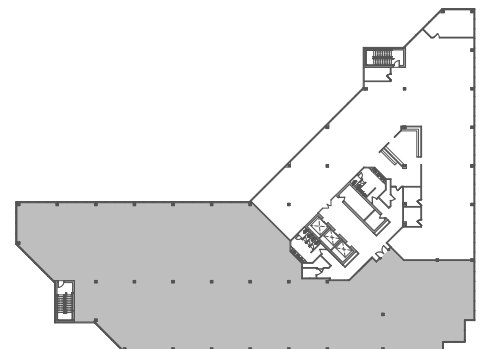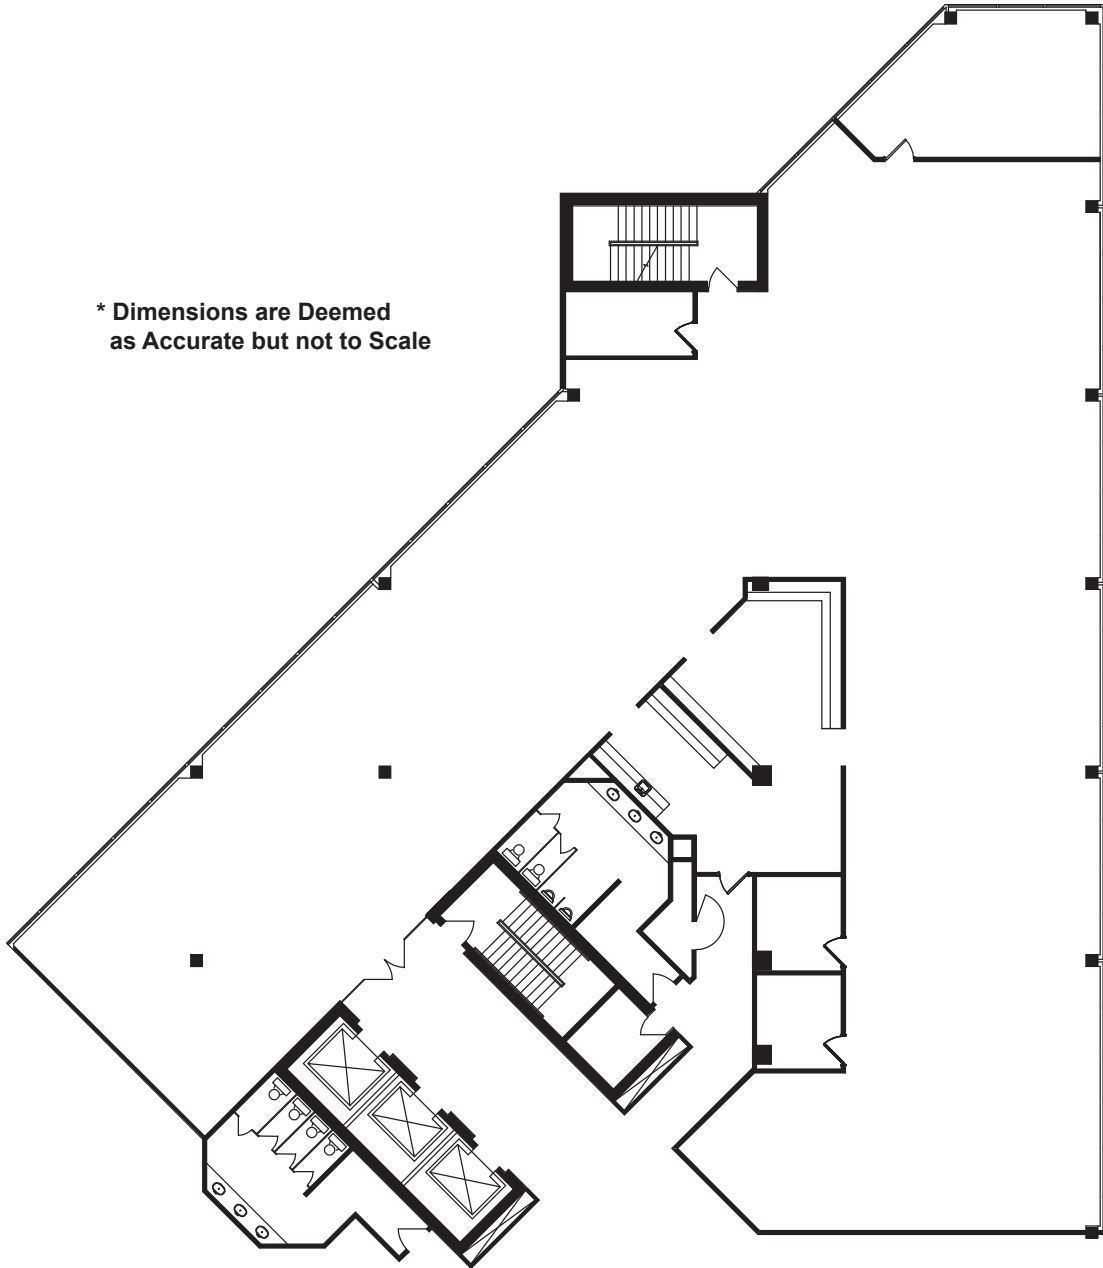

OWNED & MANAGED BY



LEASED BY

