



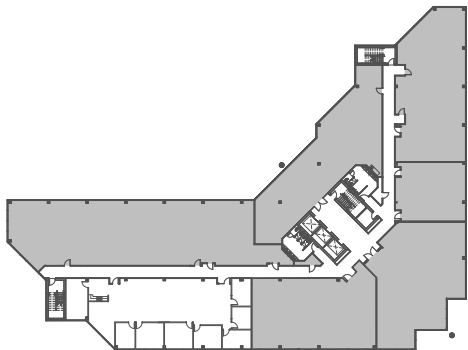

BROADWAY EAST

Suite 430

As-Built 3,839 Sq. Ft.

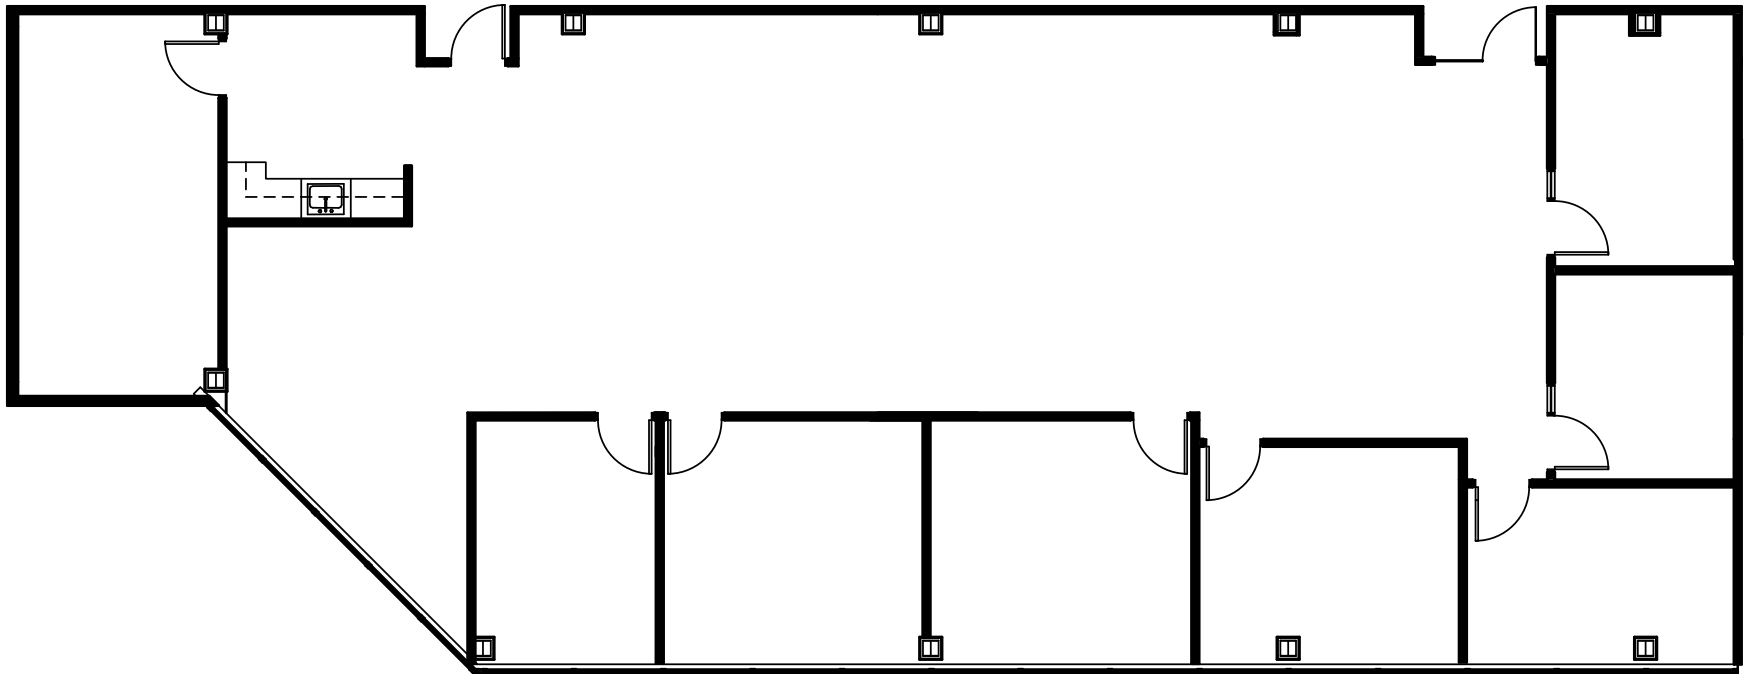

* Dimensions are Deemed
as Accurate but not to Scale

OWNED & MANAGED BY



LEASED BY

