




# BROADWAY EAST

Suite 100

As-Built 1,612 Sq. Ft.

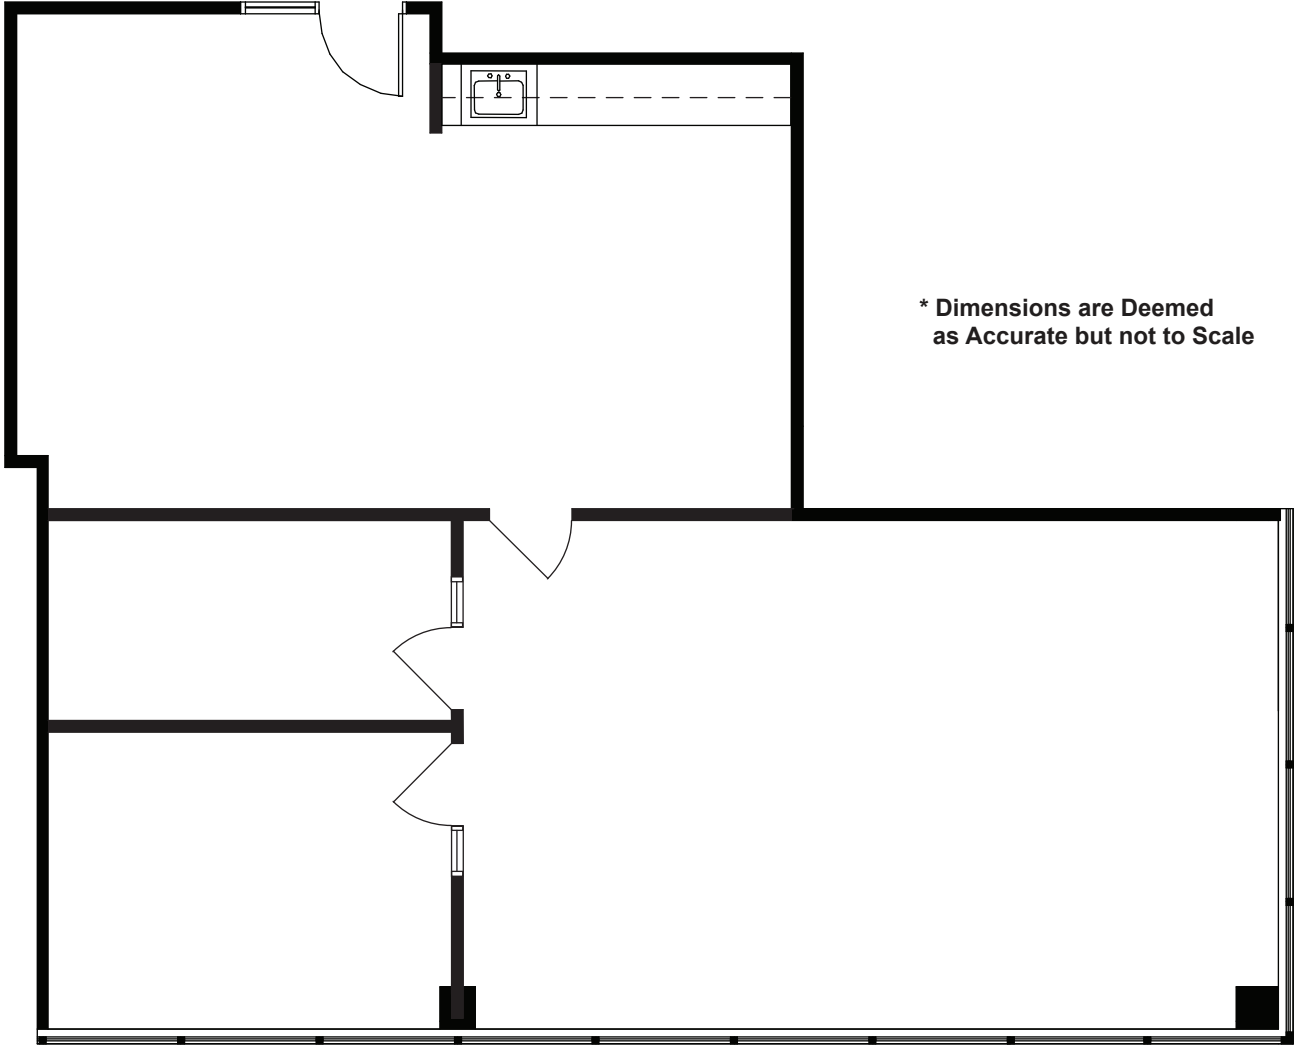

\* Dimensions are Deemed  
as Accurate but not to Scale

OWNED & MANAGED BY



LEASED BY

