



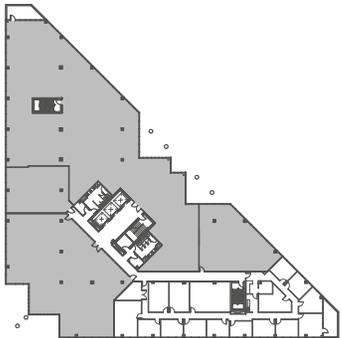

BROADWAY WEST

Suite 3950

As-Built 5,821 Sq. Ft.

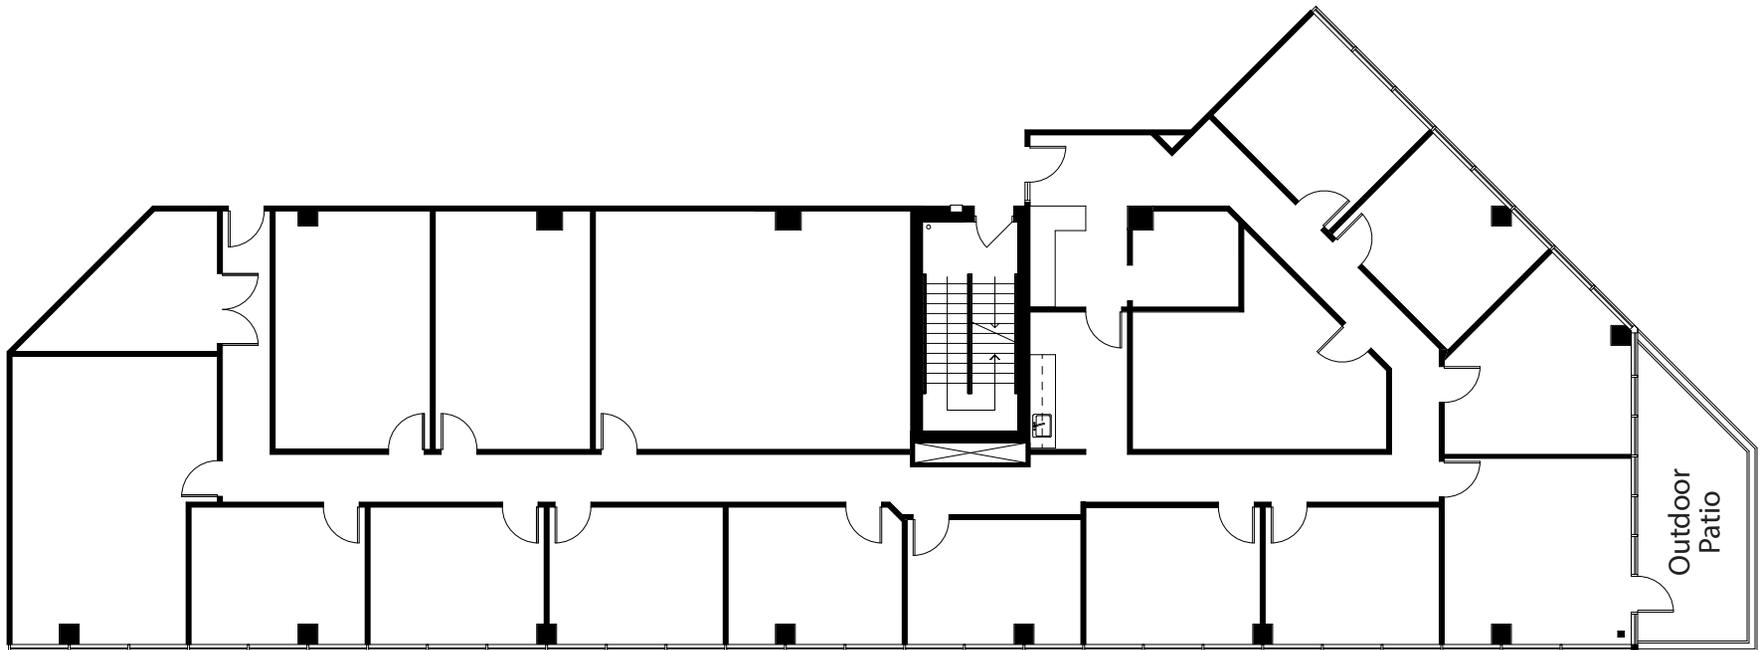

* Dimensions are Deemed
as Accurate but not to Scale

OWNED & MANAGED BY



LEASED BY

