




BROADWAY EAST


Suite 400

As-Built

3,077 Sq. Ft.

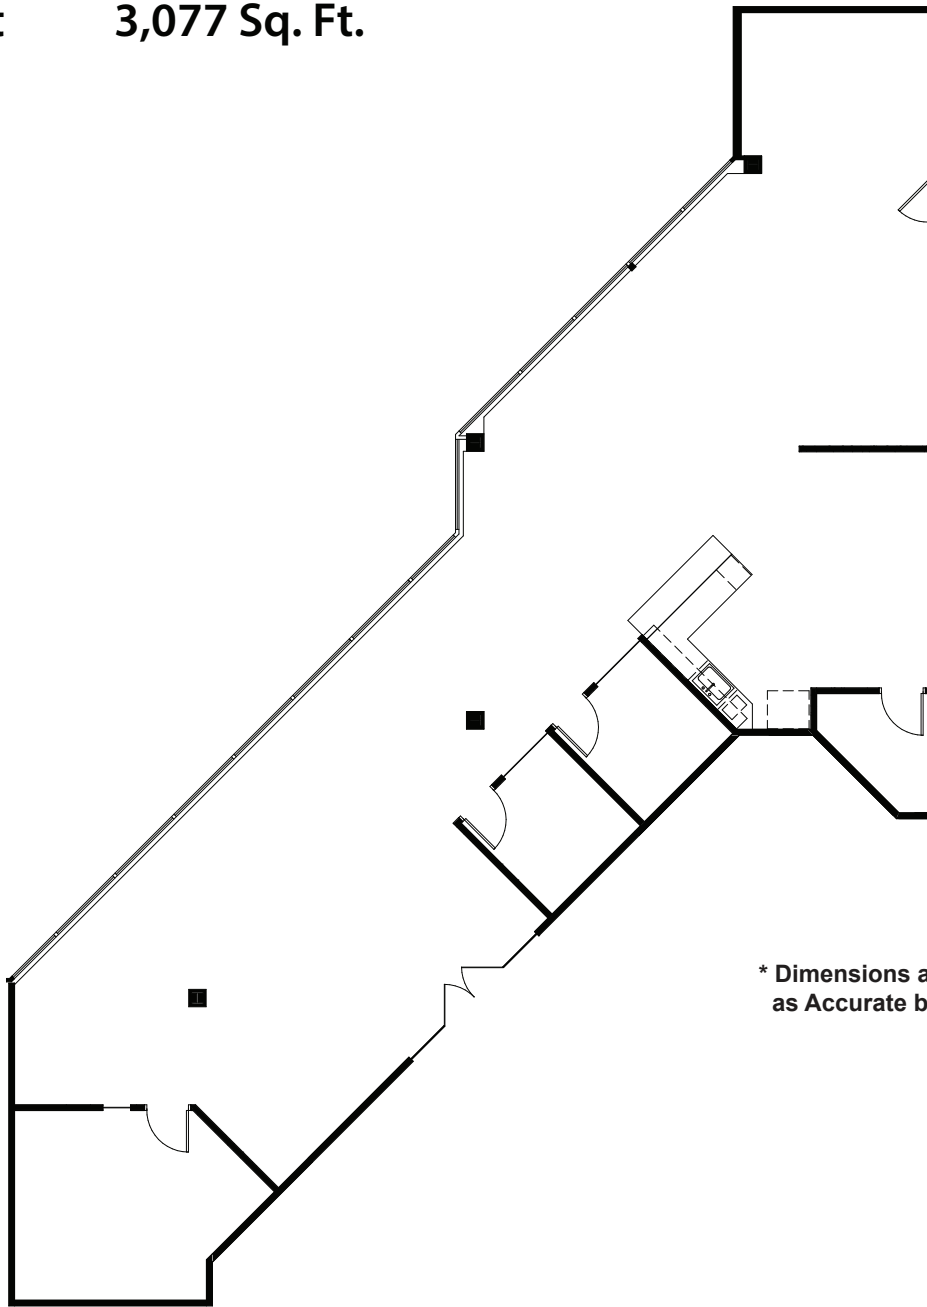

* Dimensions are Deemed
as Accurate but not to Scale

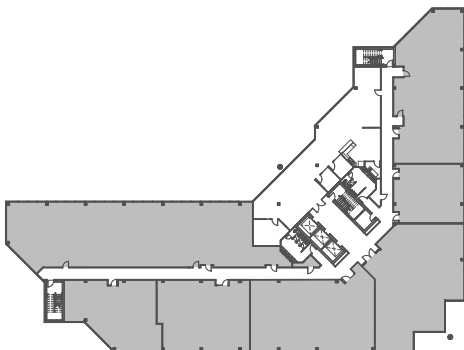

OWNED & MANAGED BY



LEASED BY

