


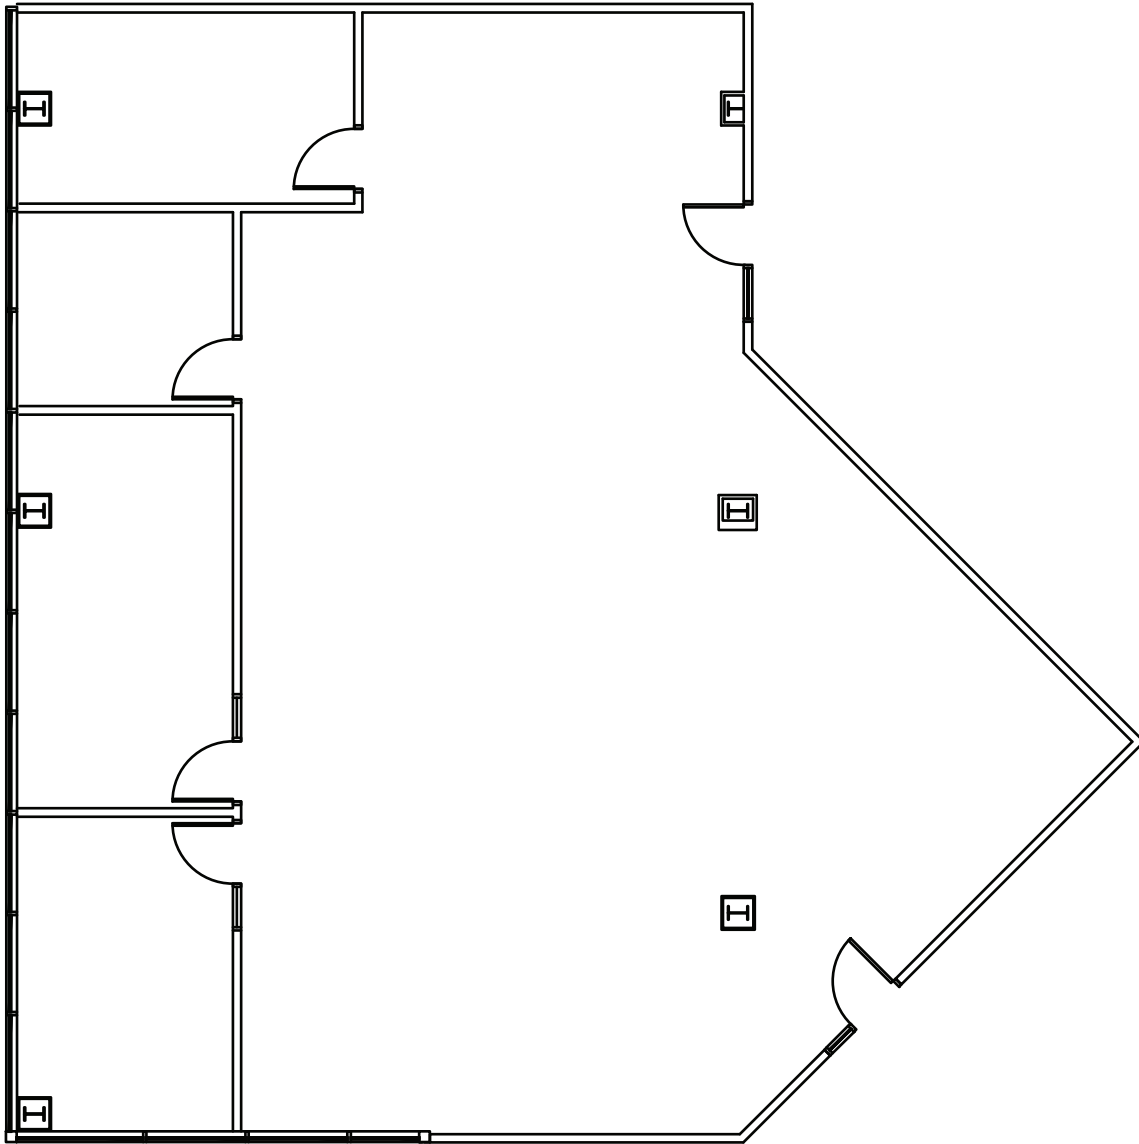


BROADWAY WEST

Suite 1200

As-Built 2,840 Sq. Ft.



* Dimensions are Deemed
as Accurate but not to Scale

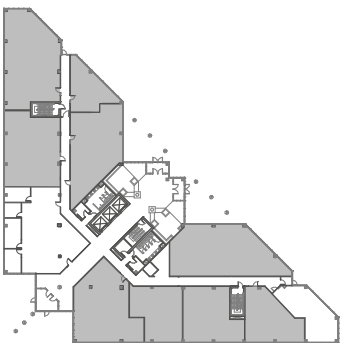

OWNED & MANAGED BY



LEASED BY

