




BROADWAY EAST

Suite 500

As-Built

24,880 Sq. Ft.

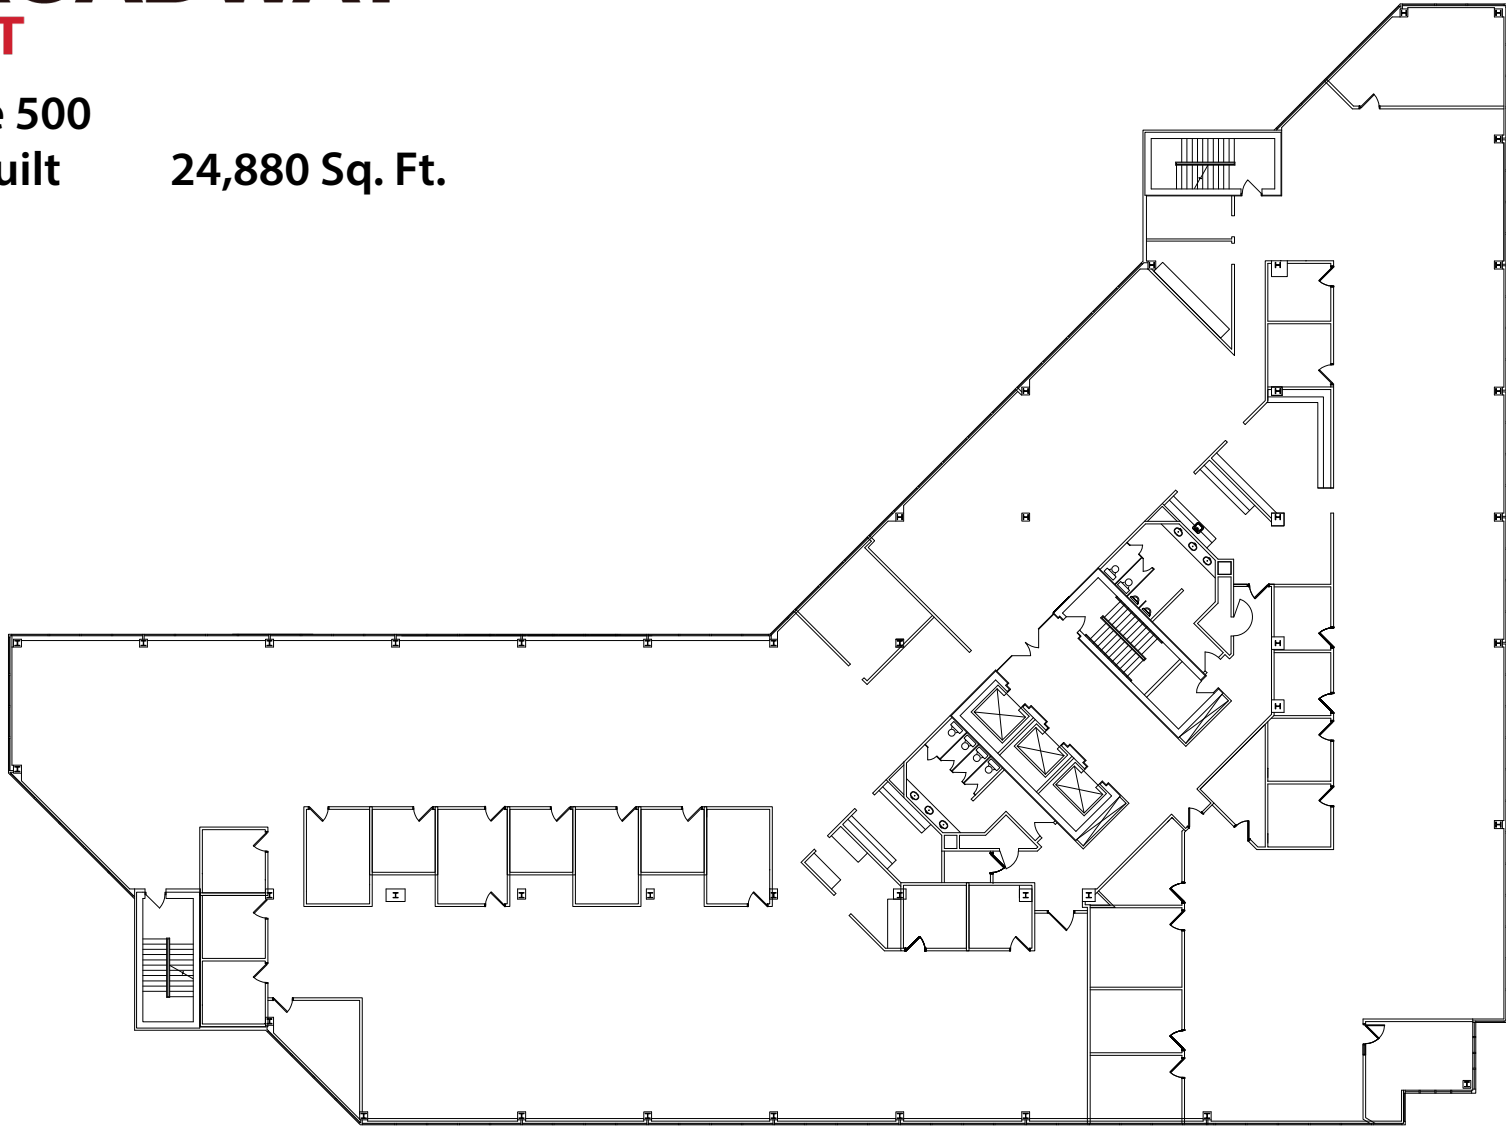

* Dimensions are Deemed
as Accurate but not to Scale