



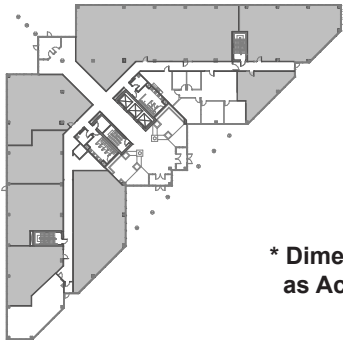

# BROADWAY WEST

Suite 1600

As-Built      2,004 Sq. Ft.

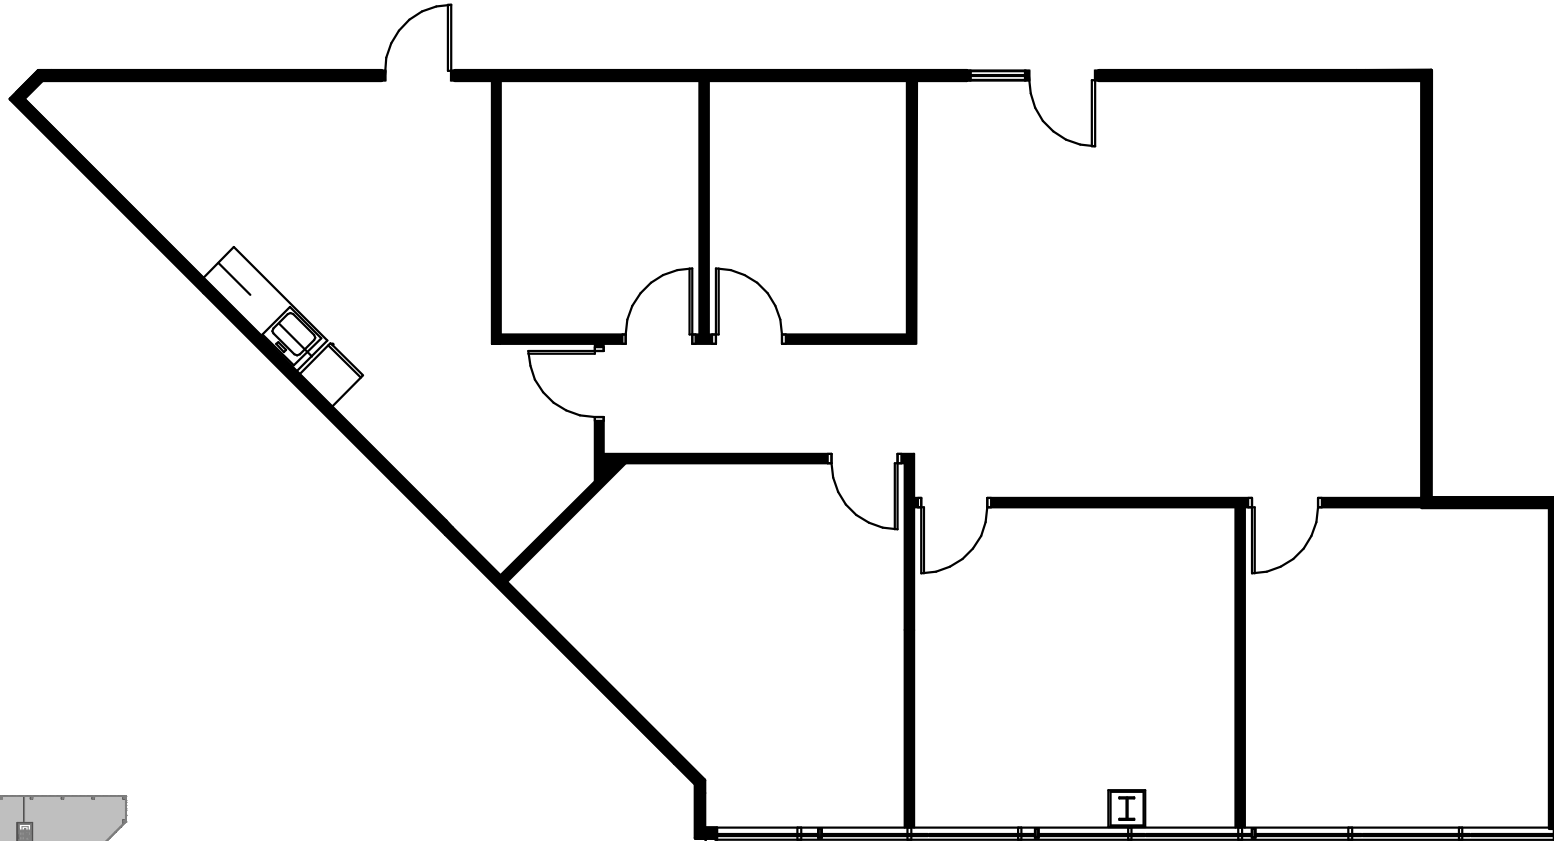

\* Dimensions are Deemed  
as Accurate but not to Scale

