




BROADWAY EAST

Suite 210

As-Built

7,980 Sq. Ft.

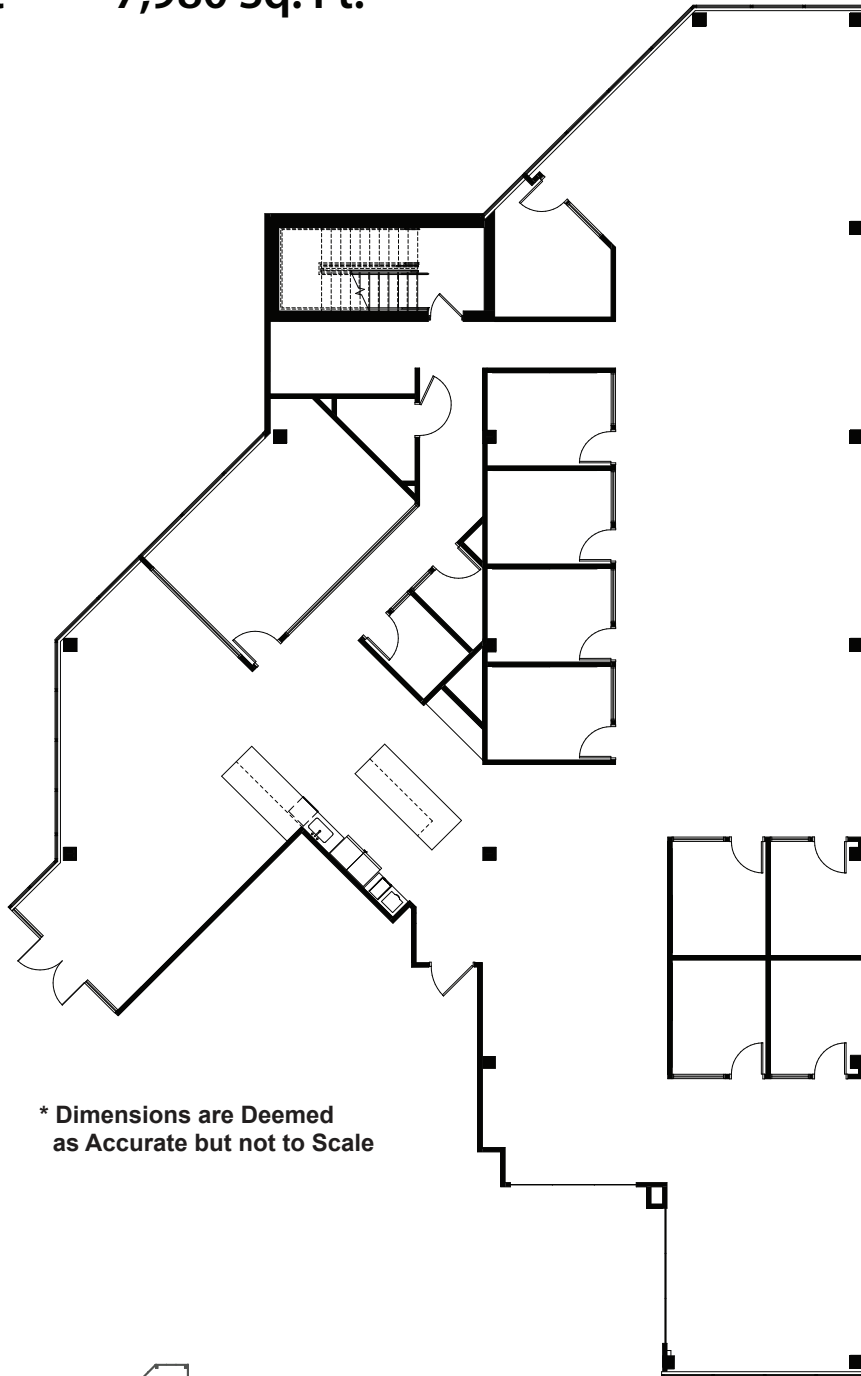

* Dimensions are Deemed
as Accurate but not to Scale

