




BROADWAY WEST

Suite 2000

As-Built 13,034 Sq. Ft.

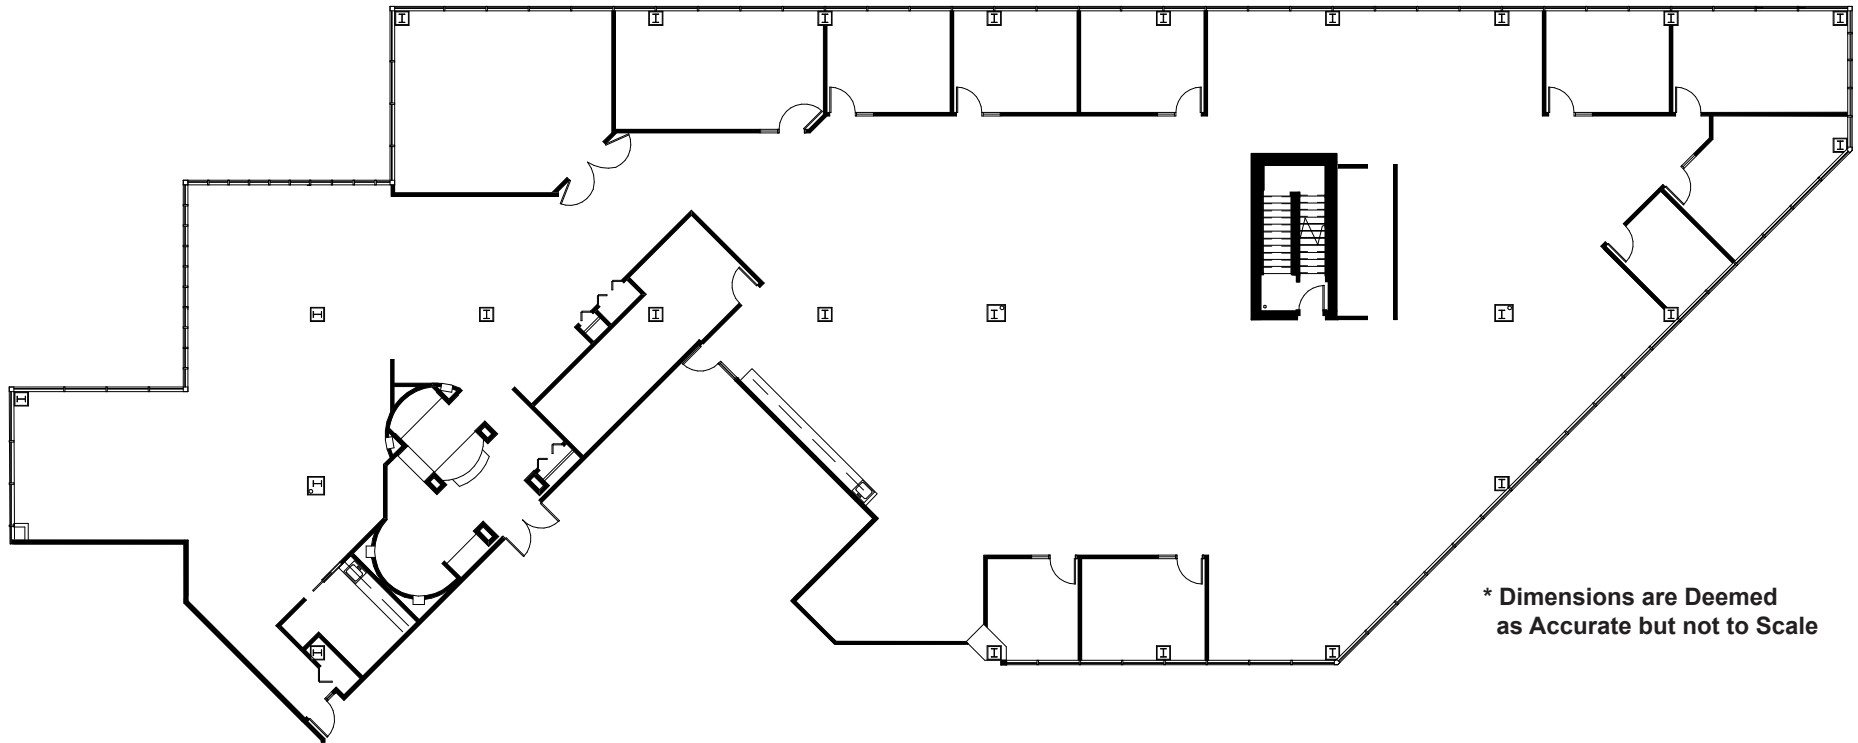

* Dimensions are Deemed
as Accurate but not to Scale

