




# BROADWAY EAST

Suite 500

As-Built

24,880 Sq. Ft.

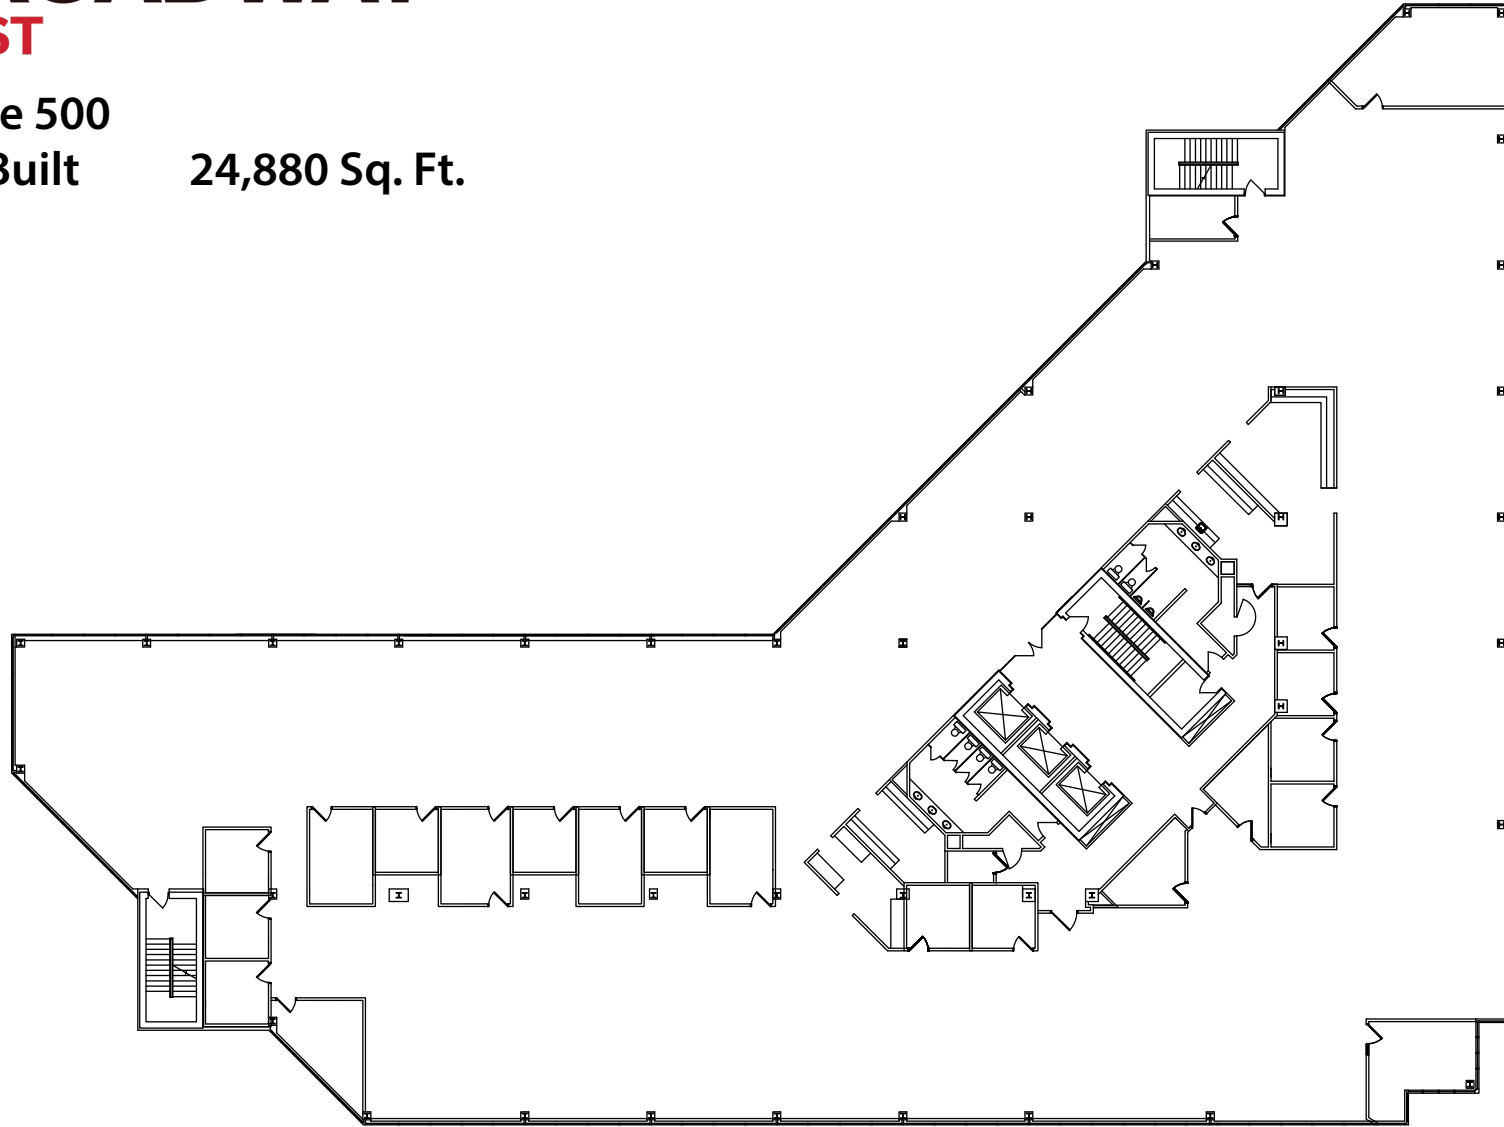

\* Dimensions are Deemed  
as Accurate but not to Scale