




BROADWAY EAST

Suite 200

As-Built 20,874 Sq. Ft.

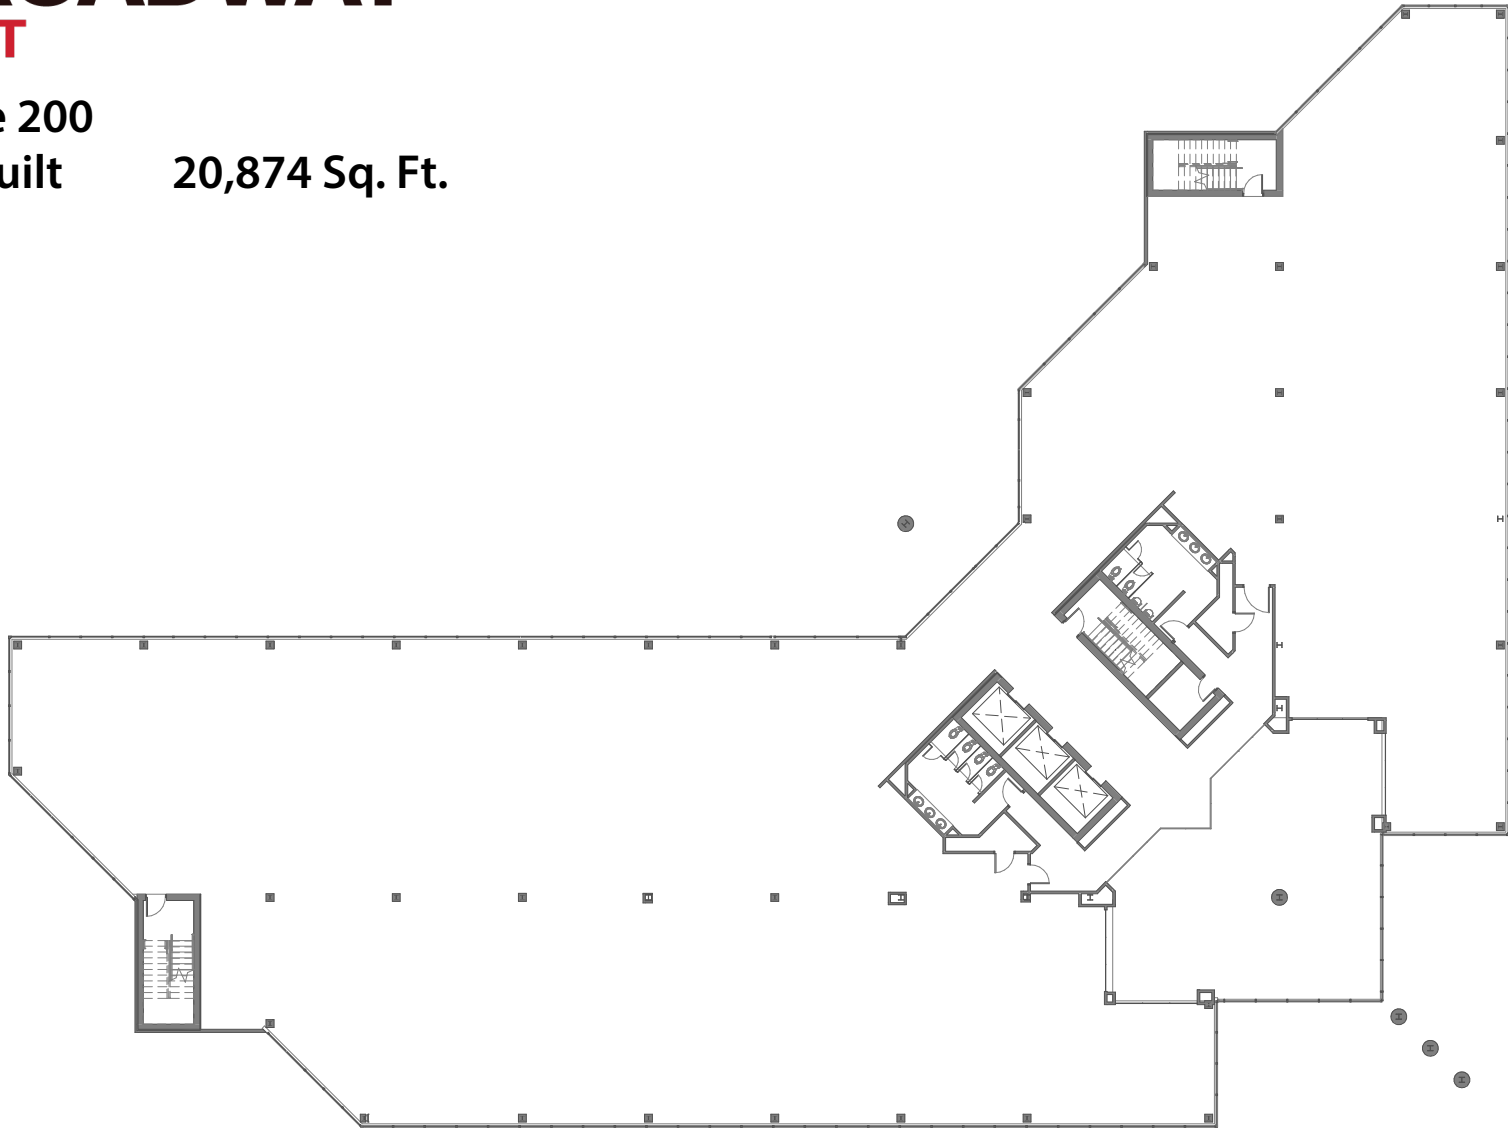

* Dimensions are Deemed
as Accurate but not to Scale