




BROADWAY WEST

Suite 3100

As-Built 10,863 Sq. Ft.

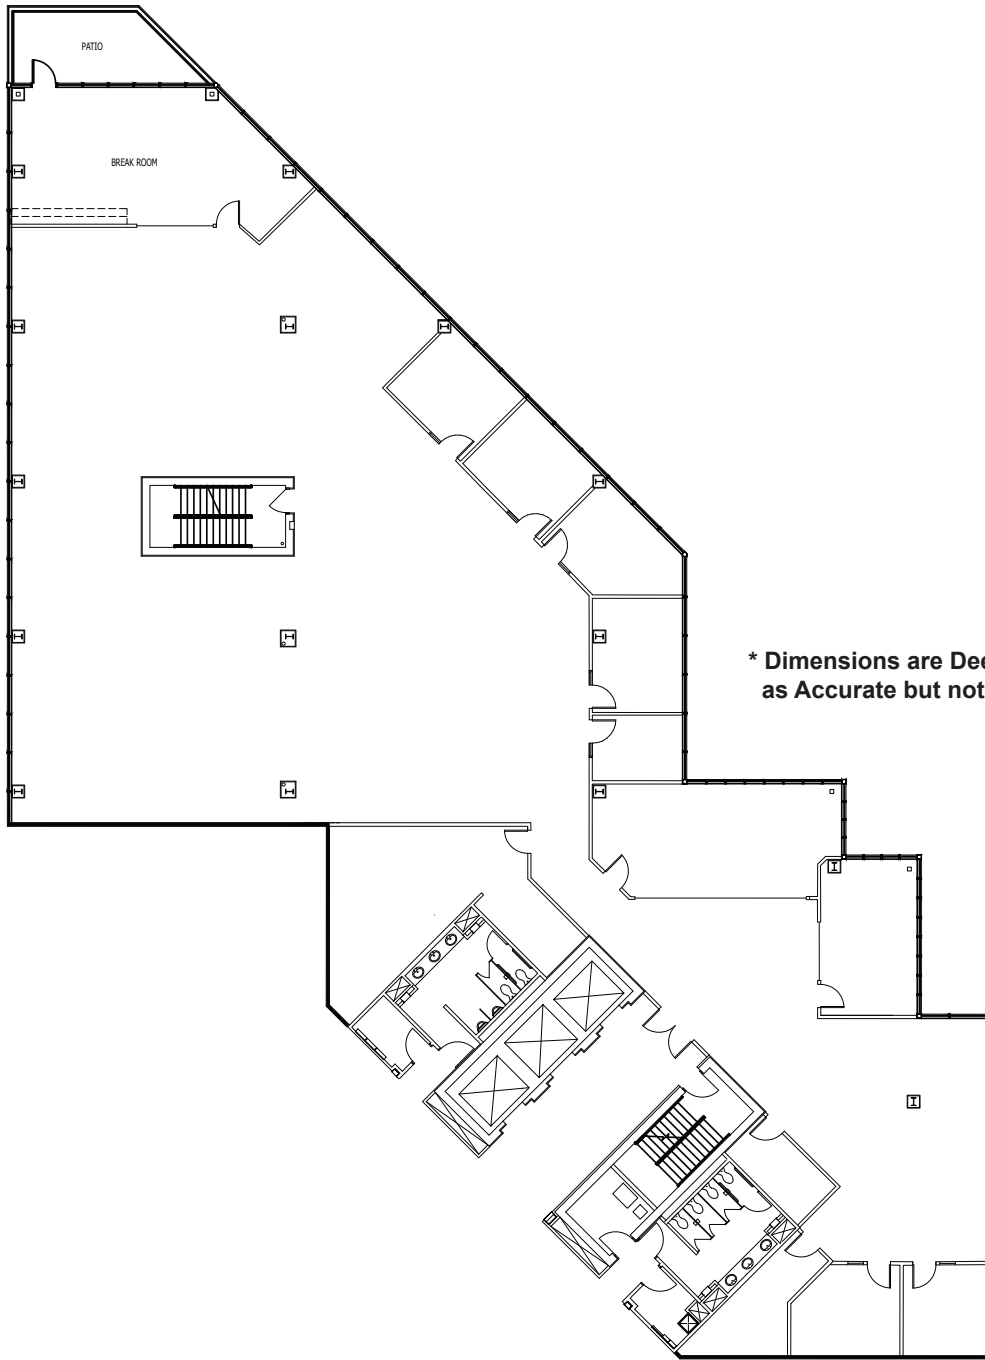

* Dimensions are Deemed
as Accurate but not to Scale

