




BROADWAY WEST

Suite 4250

As-Built 9,739 Sq. Ft.

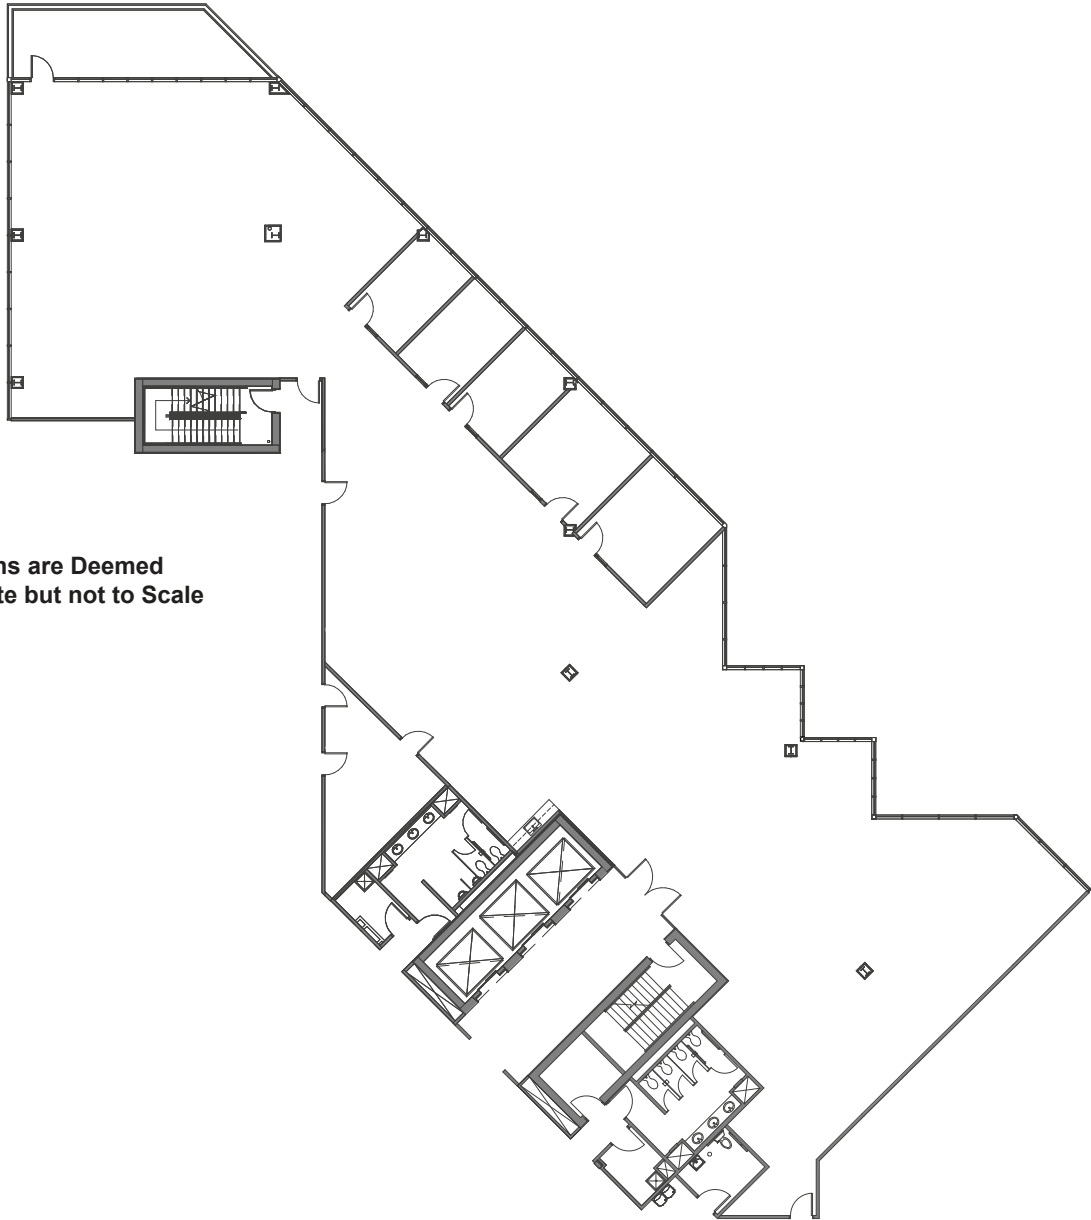

* Dimensions are Deemed
as Accurate but not to Scale

