




BROADWAY RIDGE

Suite 110

As-Built 2,791 Sq. Ft.

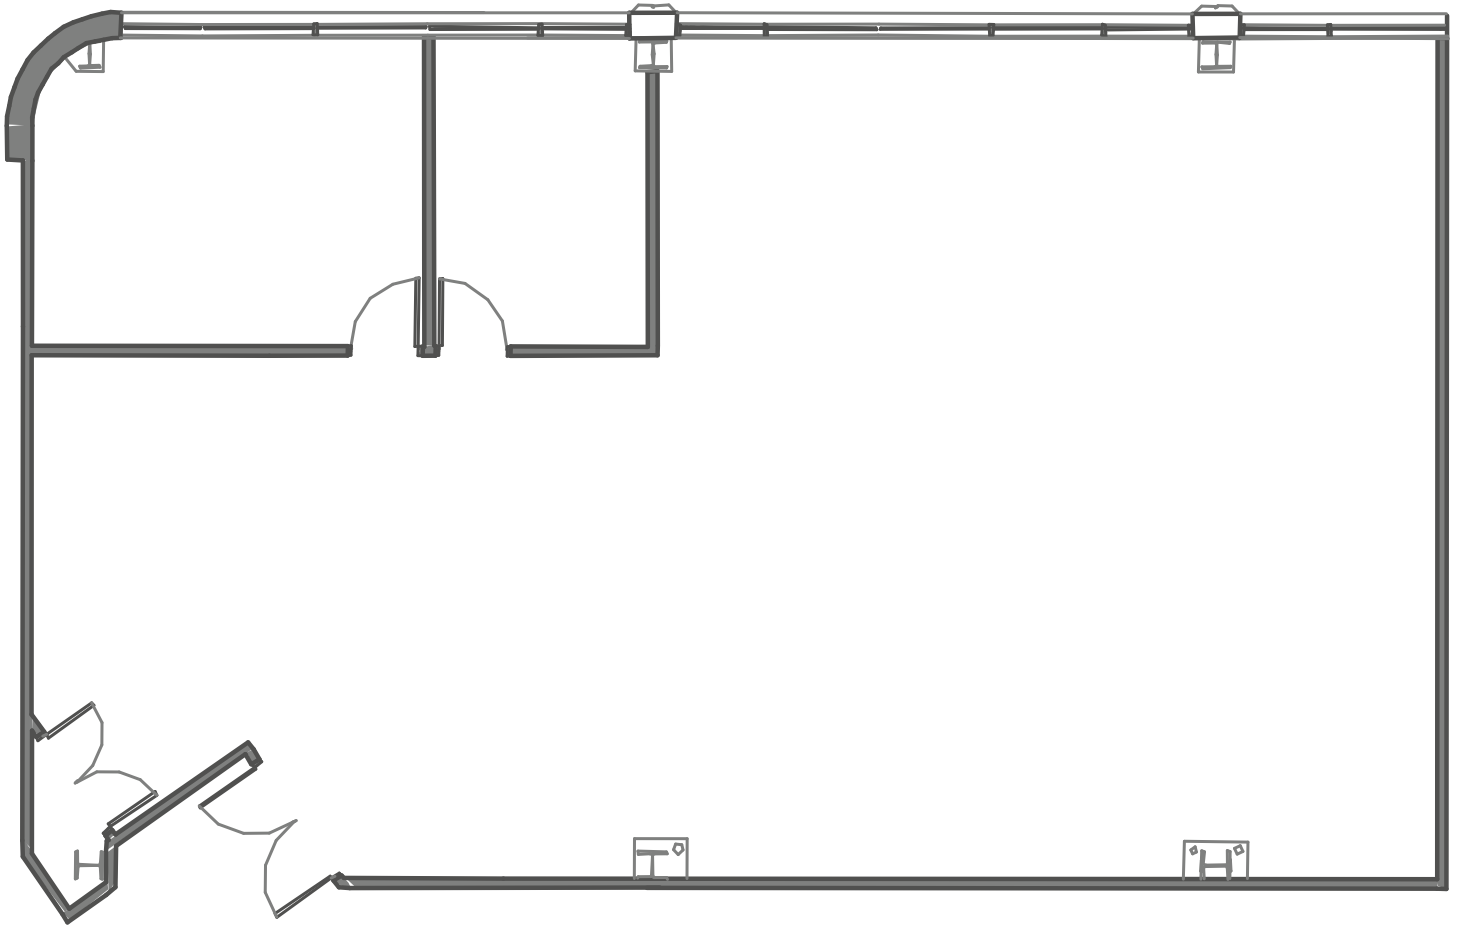

* Dimensions are Deemed
as Accurate but not to Scale

